



SIEI

9-2

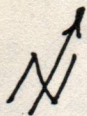

GREENBRICK STREET

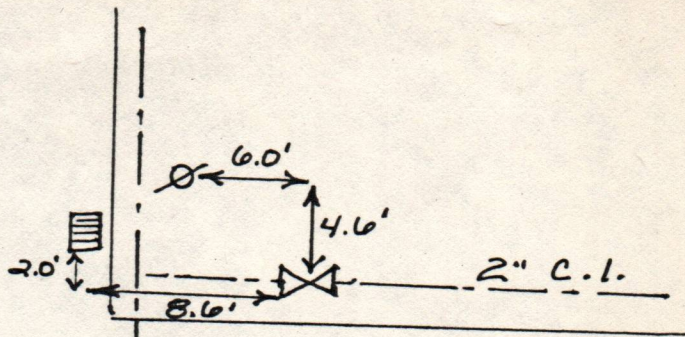

SHORT ST.