



SIE3

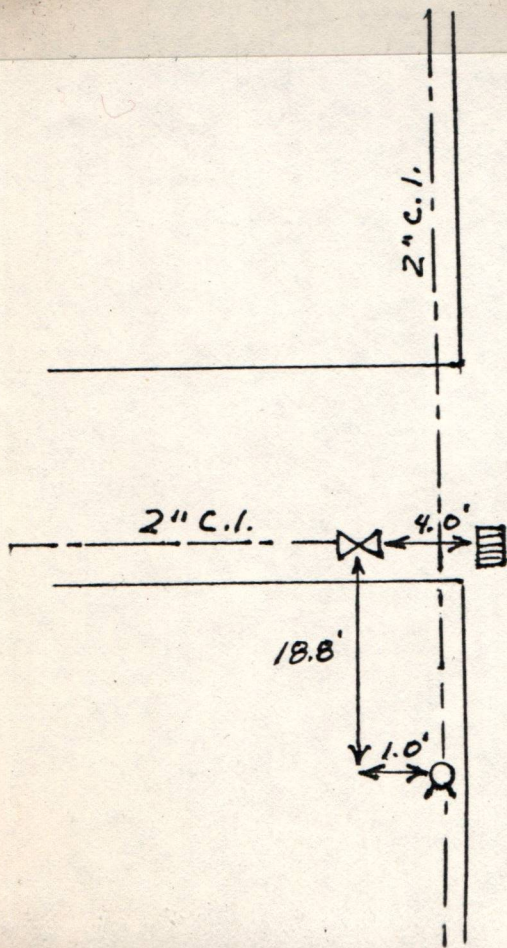

DRIVE

HUGHES

WILDWOOD CR.

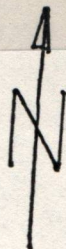

11-1