


6-1

SIE4.

EMERGENCY
TIE-IN TO
W.V. WATER

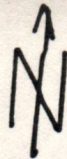

8" C.I.

35.6'

KANAWHA TER.

17.0'

Ø
I.P.

CITY LIMITS

STARLIT
DRIVE

