



SIW2

1-4

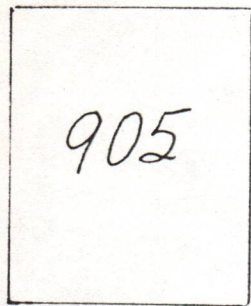

DRIVE

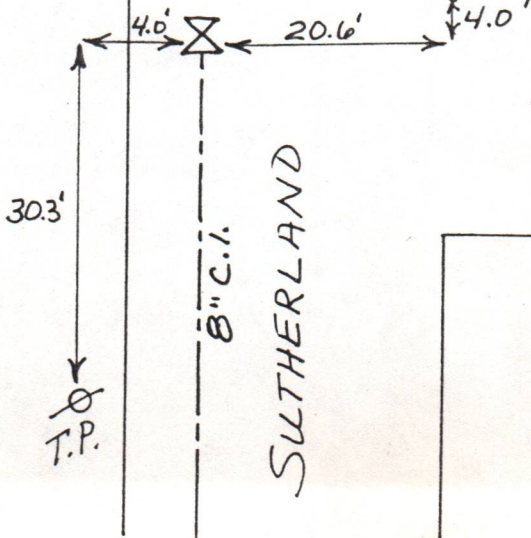

SUTHERLAND