



SIW2


11-1

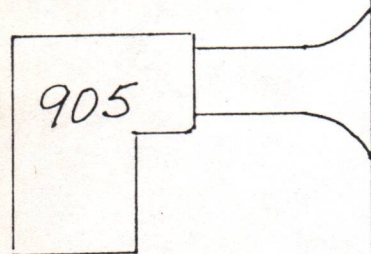

WOODSIDE DR.

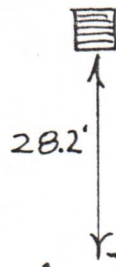

161A102

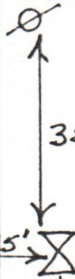

2 1/4" C.I.

JACKSON ST.

