


SIW2

2-1

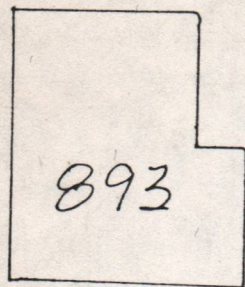

Painted Red
Valve closed!

SO. WASH. STREET

