


SIW2

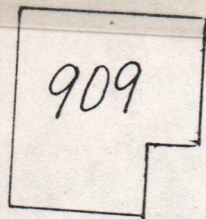

909



BAIER

2 1/4" C.I.

LIVELY ST.

36.0'


STREET

38.2'

9
6
-
6

13.8'

9.0'

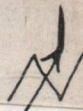

4-1