


SIW2

4-2

WOODSIDE DRIVE

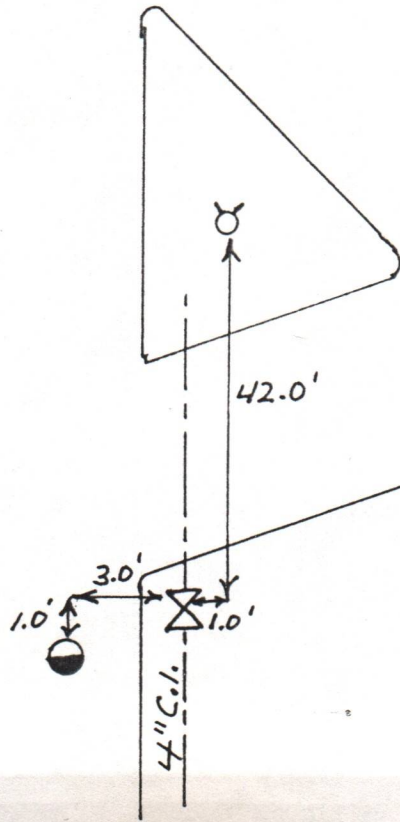

BAIER STREET

