


2-2

51W3

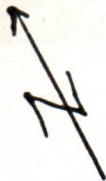

12" CI

75'

12" CI

unimproved

Road

