
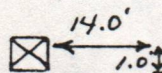
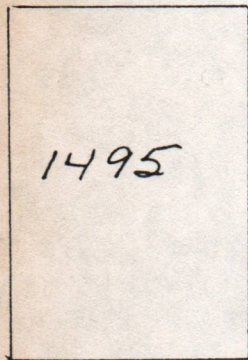



7-1

SIW3

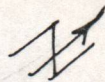

14.0'

1.0'

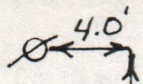

4.0'

59.3'

8" C.I.

PENNSYLVANIA AVE.

8" C.I.

TO TANK
(HIGHLAND)