



S2E2

14-1

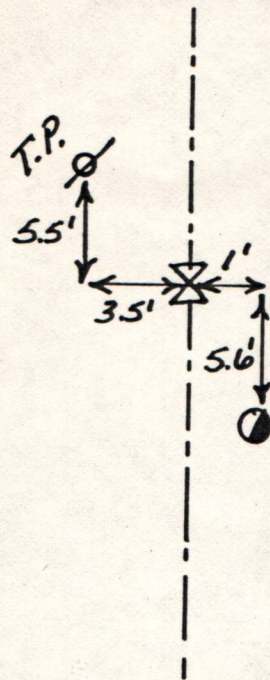

S.O. WALNUT DR.

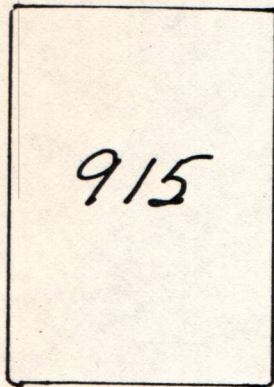