


52E2

22-4



LEXINGTON DRIVE

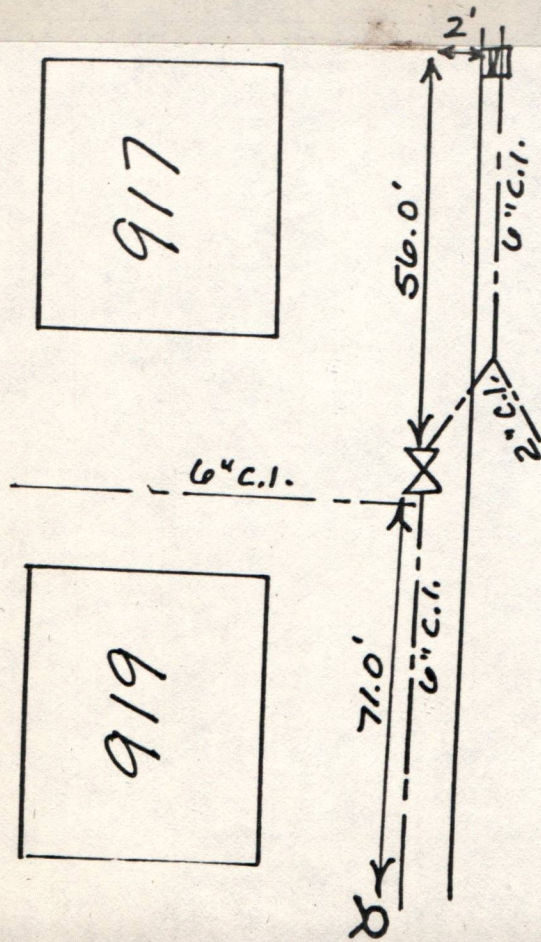