



S2E2

24-1

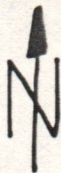

SUMMIT DRIVE

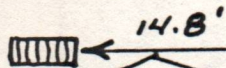

14.8'

3.5'

6.9'



9.8'

2" C.I.

1124