
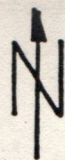


S2E2

5-1

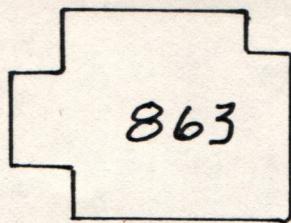

LEXINGTON

POPLAR

6" C.I.

