


20-2

S2E3

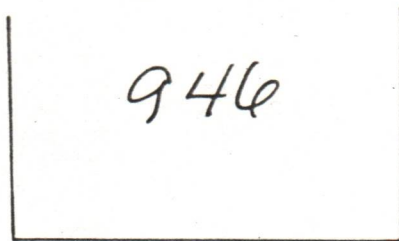

946



6" C.I.

POPLAR

DRIVE

6" C.I.

9.7'

26.8'

1.0'
Ø

LAING

