


5-1

Wildwood Cir.

S2E3

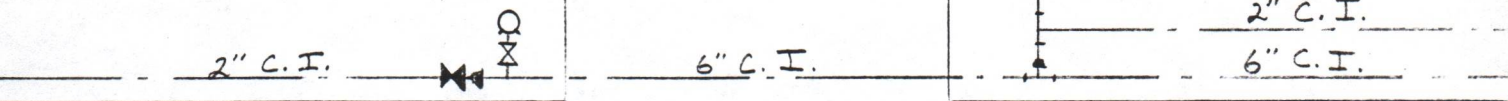

HUGHES DR.

Top of Hughes Dr. & Wildwood Cir.