


52W2

5-1


1390

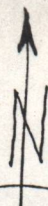

WOODSIDE
DRIVE



HIGHLAND DRIVE

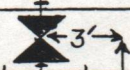


6" C.I.

9' 6"



HIGHLAND
APT.

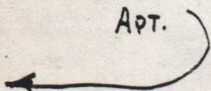

JAMES ADKINS