


PENNSYLVANIA      AVE.

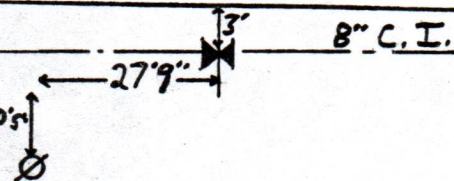

SLIP AREA