


S2W5

21-1

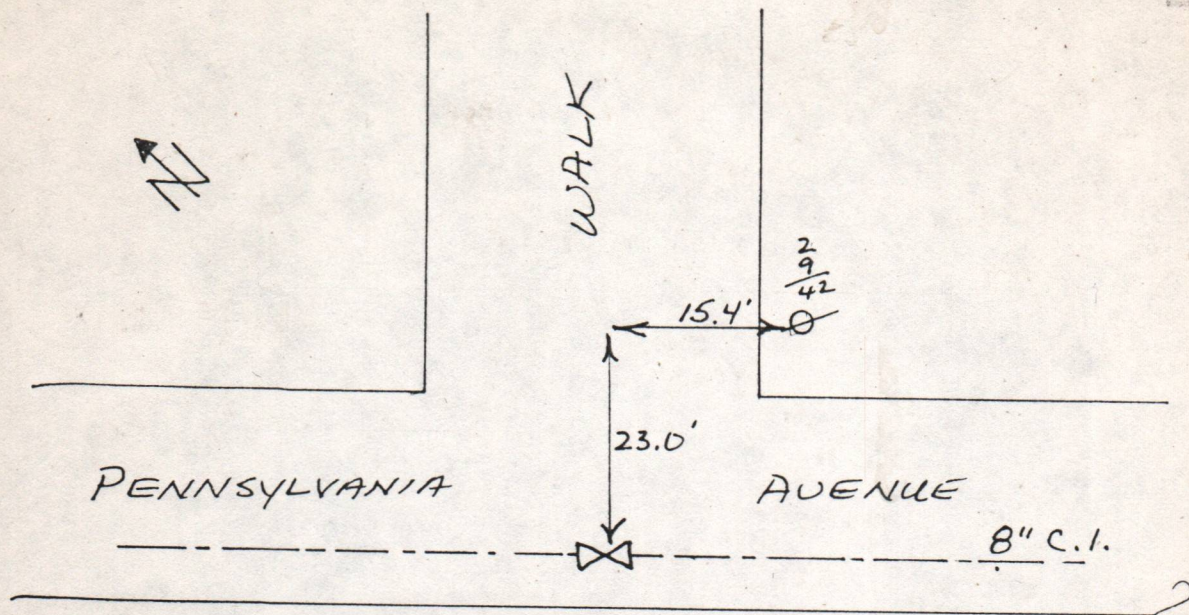

2089