



52W7

24-1

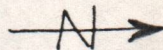

WINTER STREET

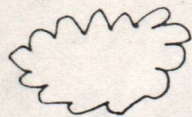