



S2W7

24-2

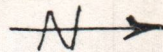

WINTER STREET

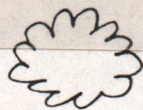