


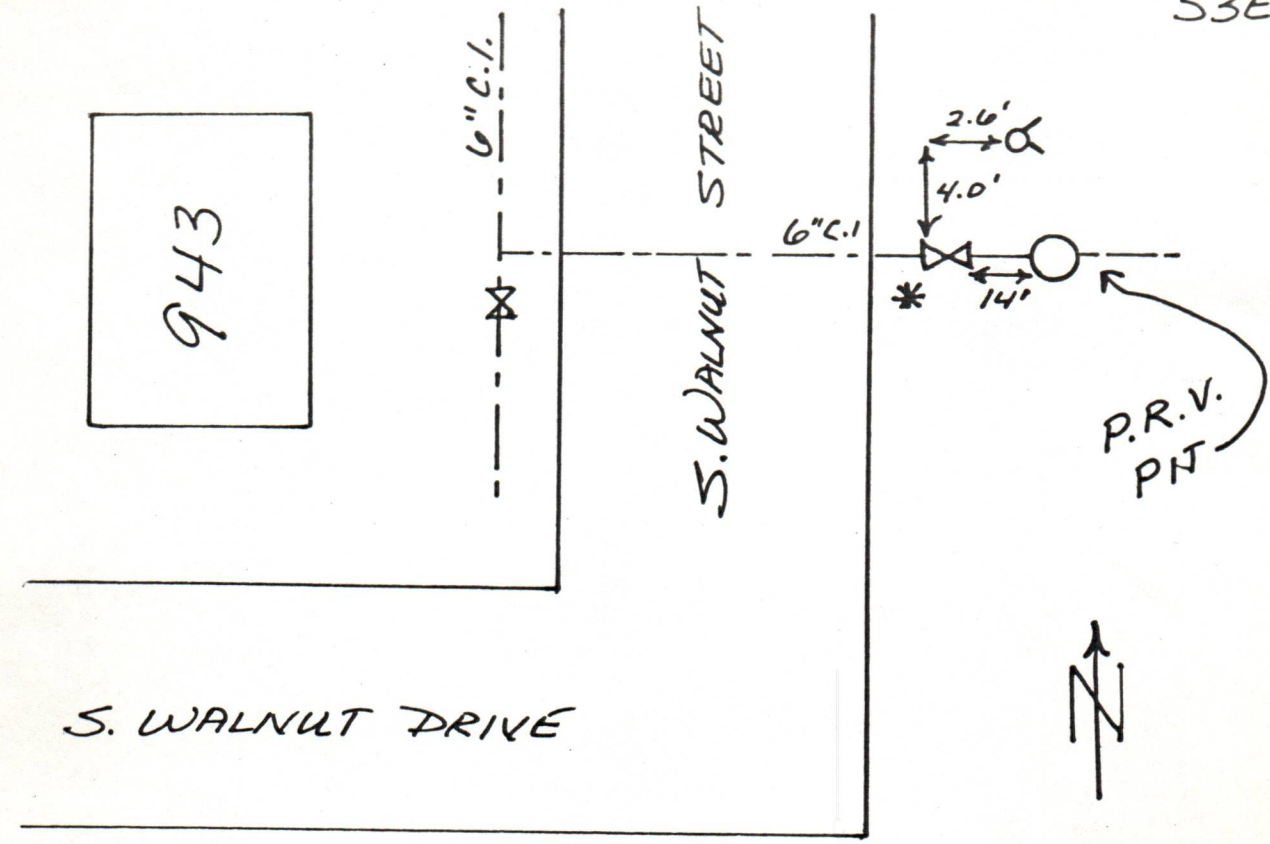

* NOT SHOWN ON MAP