
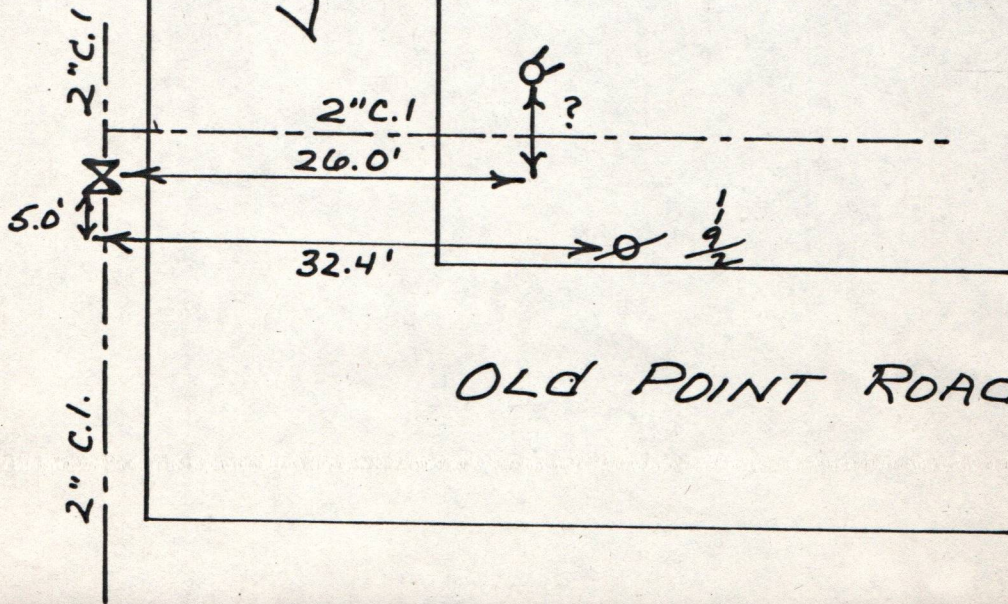


18-1

S3E2

977

LAING ST.

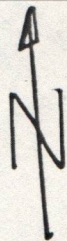

OLD POINT ROAD