


S3E2

949

947

22-19-22-2

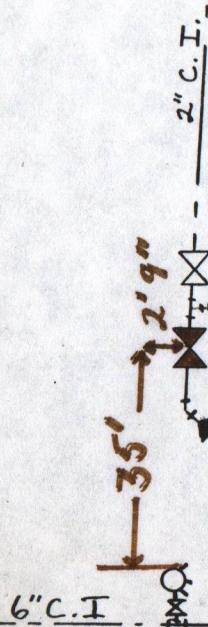

2" C.I.

3" C.I.

LEXINGTON DR.

4" PVC

6" I.D.

CREEK

