


S3E3

10-1

958

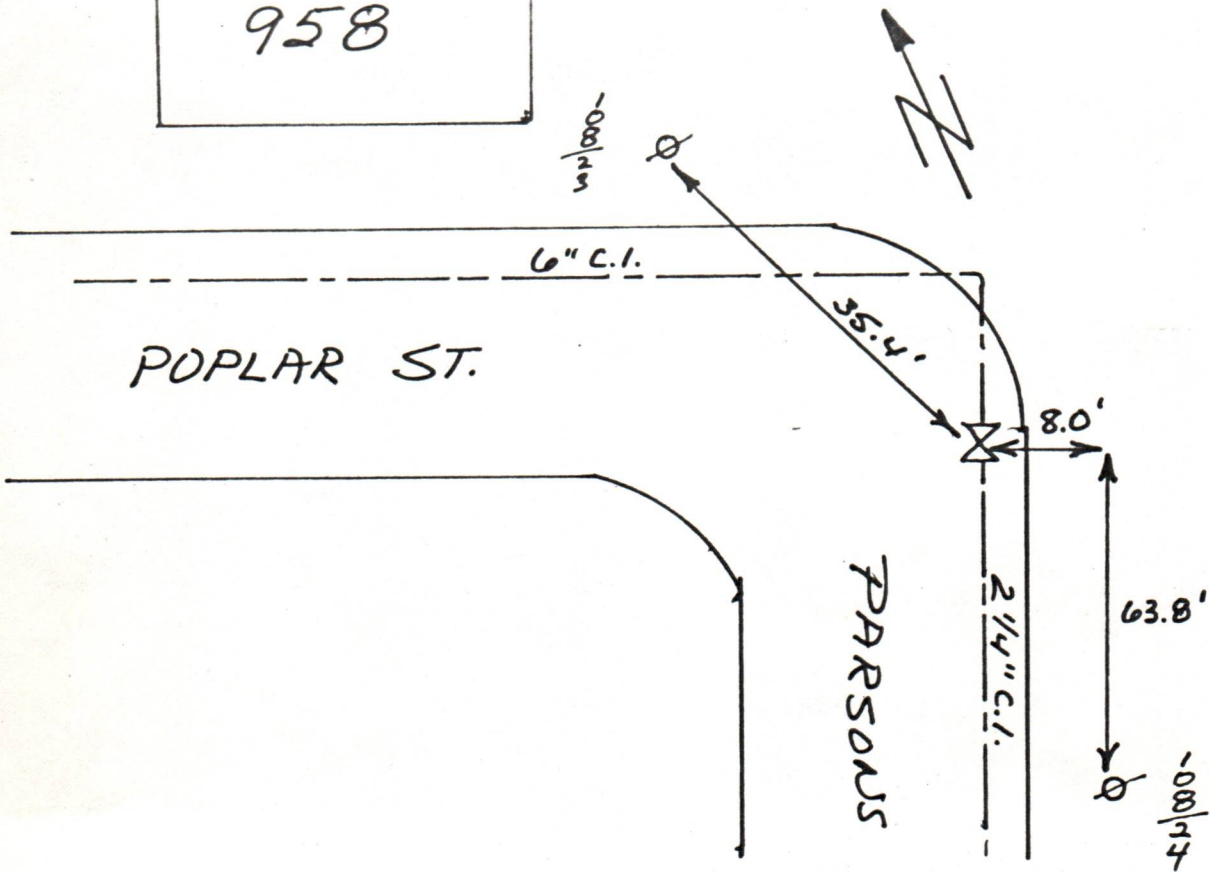

6" C.I.

POPLAR ST.

35.4'

8.0'

PARSONS

2 1/4" C.I.

63.8'

-0.00/ft

-0.00/ft