



53E3

988

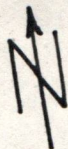

965
ELLIOT

15-1

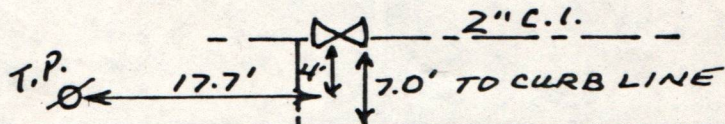

ZERKLE

STREET

BEN ROAD

991