


S3E3

3-1



LOTUS RD.

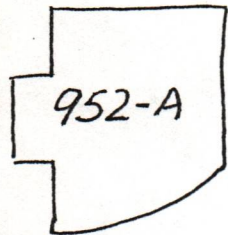

$\frac{1000}{22}$

22'

23'

POPLAR

DRIVE

6" C.I.

35'

5'

14'

3'

ELLIOTT

