



S3E3

3-2

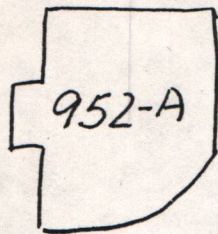

LOTUS RD.

2 1/4" c.l.

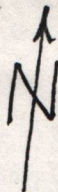

POPLAR

DRIVE

36'

3'

2'

12'

ELLIOTT

