


S3E3



POPLAR

LOTUS RD.

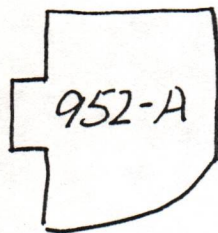

3-3

DRIVE

ELLIOTT

