


17-1

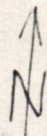

S3W4

Allen White Lane.

2" CI

8" CI

161912

27'

15'

Penn. Ave.

