


18-1

53W4

ALLEN WHITE LN.

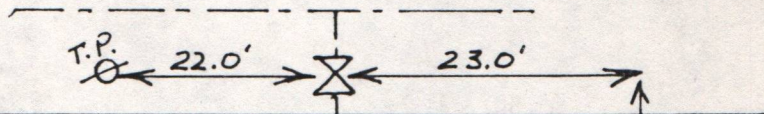

6" C.I.

PENNSYLVANIA AVENUE

41.0'

T.P.

TO
SUN VALLEY

