


9-1

S3W7

2601

6" C.I.

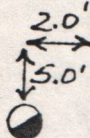

2.0'
5.0'

PLANT

27.6'

Ø 2 9/16"



LAKEVIEW

SAND

DRIVE

RIGHT
OF
WAY