


2709

LAKEVIEW DRIVE

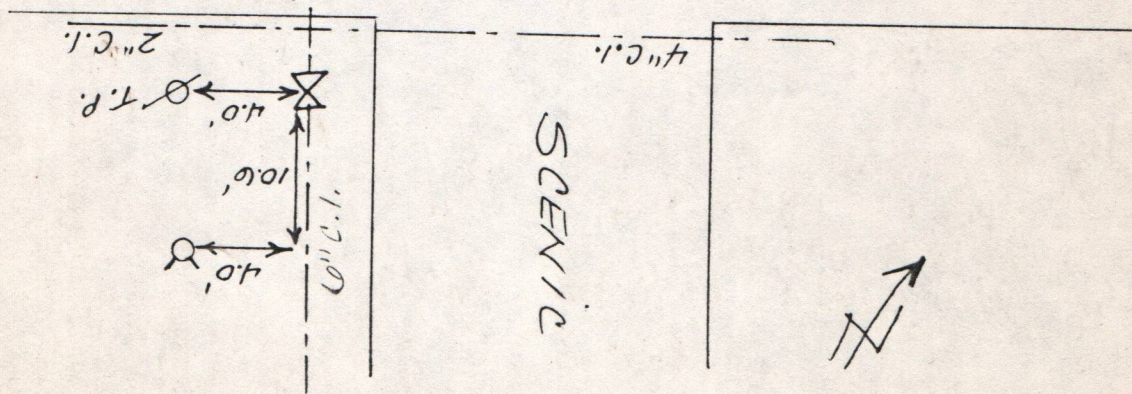

SCENIC

53W8