


S3W8

15-1

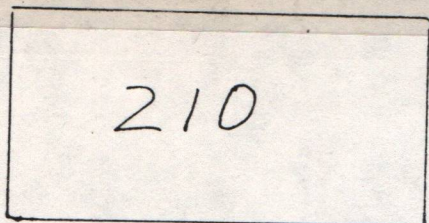

210

