


23-1

S3408



160C128

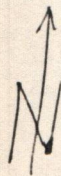

4" CI

38'

Parkview Drive

Playland Drive

12'

2 1/4" CI