


53W8

3-1

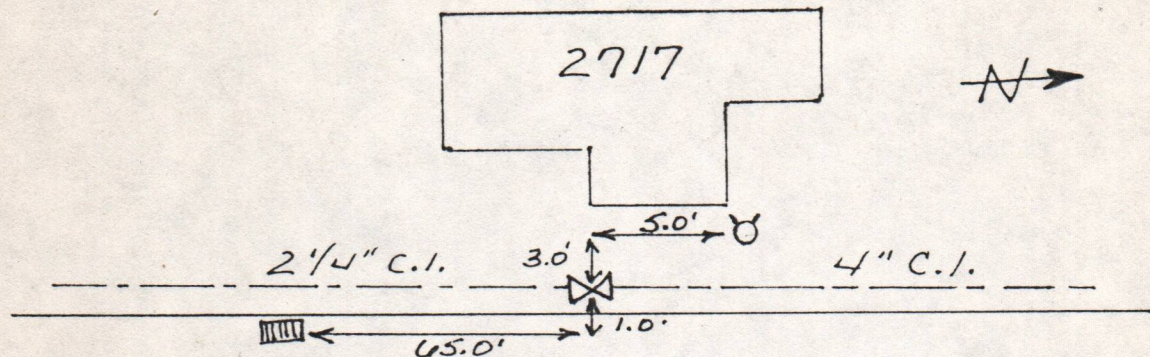

RIVERSIDE DRIVE