
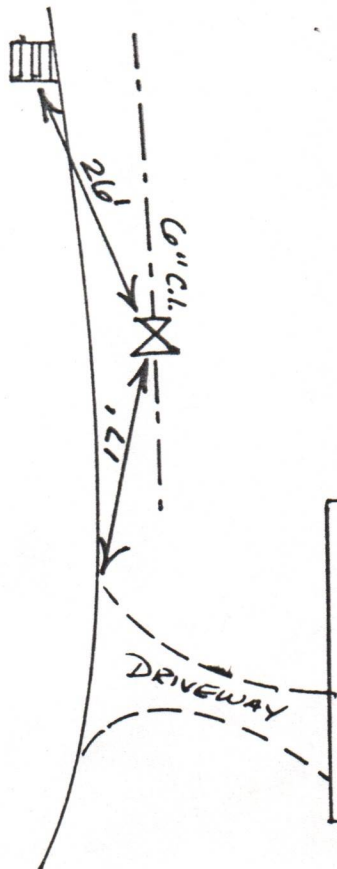


S4W5

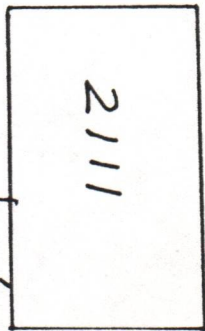

OVERLY DRIVE

21-1