


7-1

Lith



S4W5

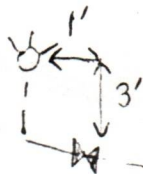

6" CI

Woodhill Place