


9-1

S4W5

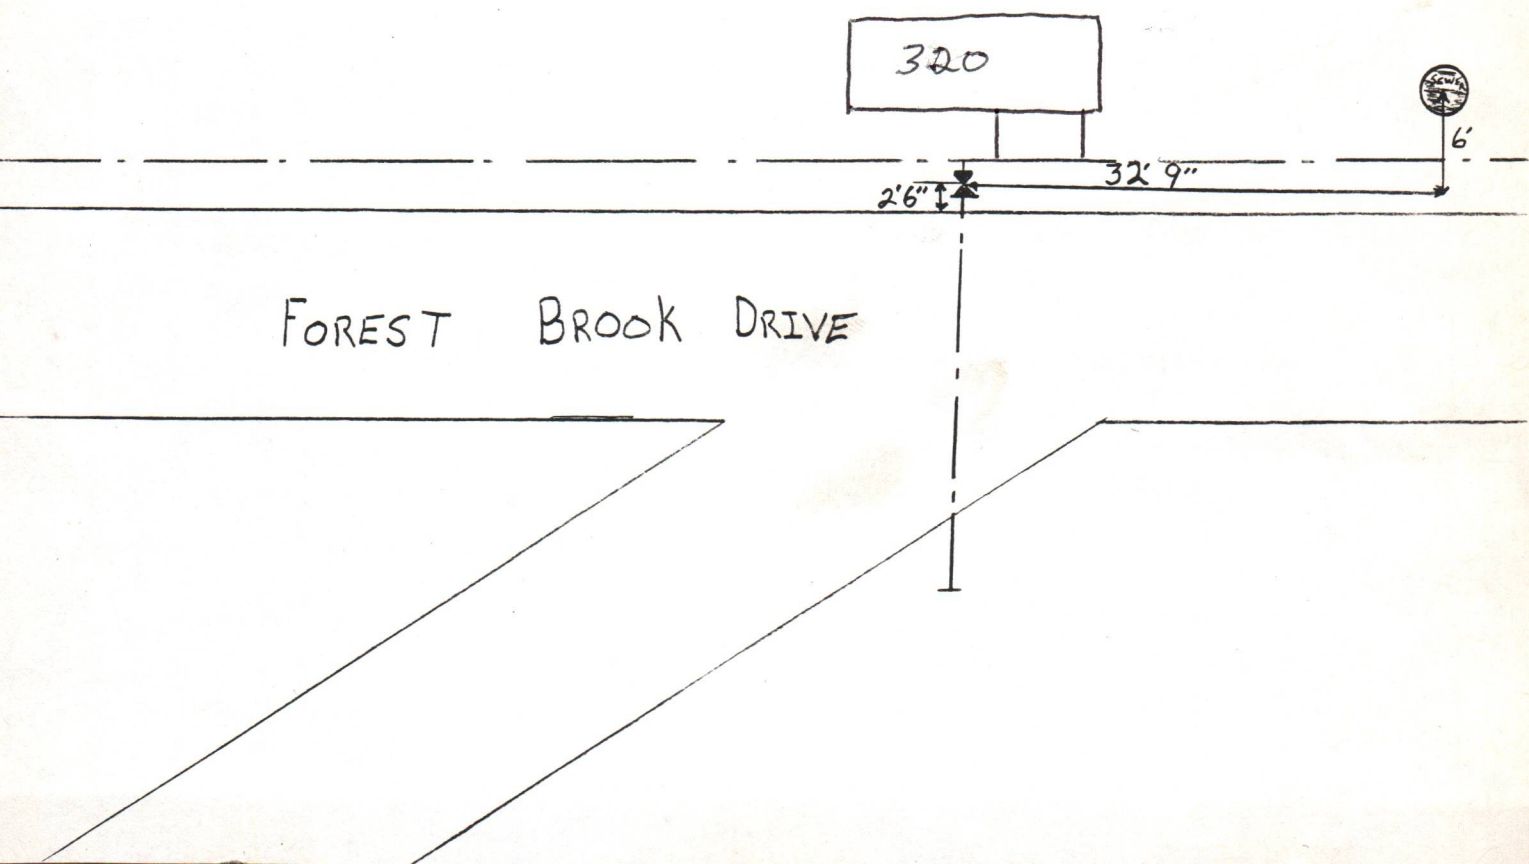

FOREST BROOK DRIVE