



S4W6

Sutherland
Dr.

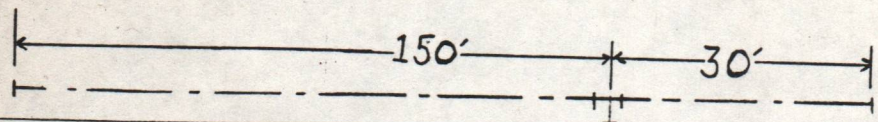

SHADYSIDE RD.

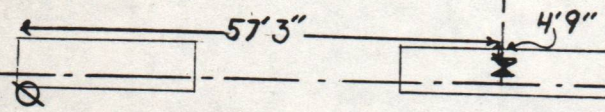

LAKewood
Vol.
FIRE Dept.

PARKING Lot