


14-2



160 A 162

S4W8

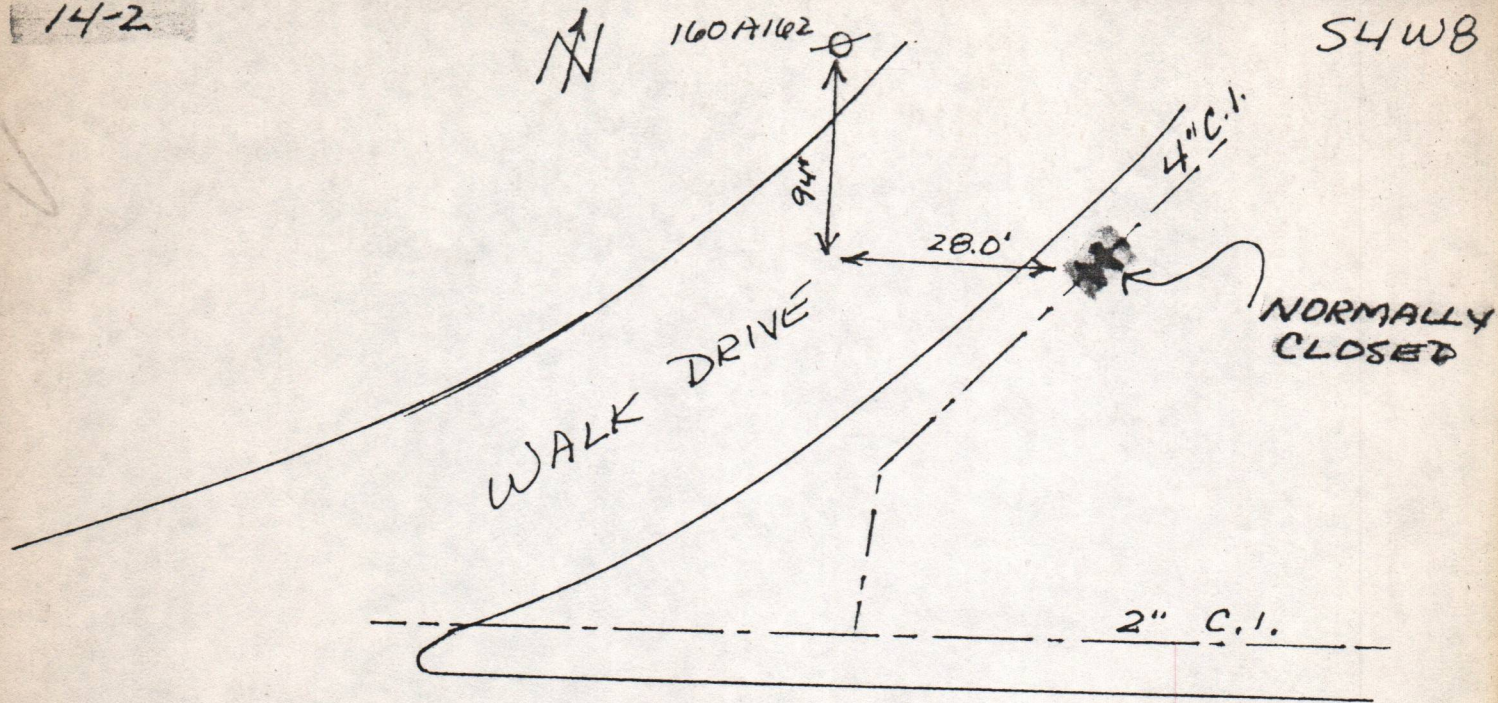

SHADYSIDE ROAD