



5-1

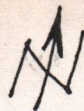

54W8

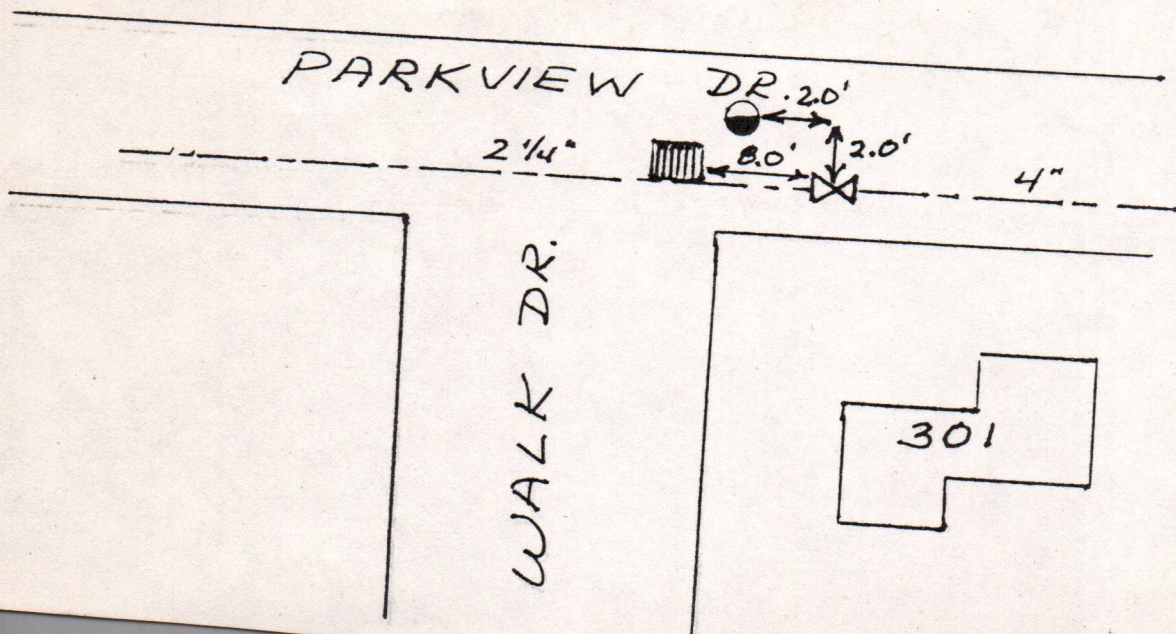

K&M CO.

TORRANCE, CA

SPOT CLEAR