
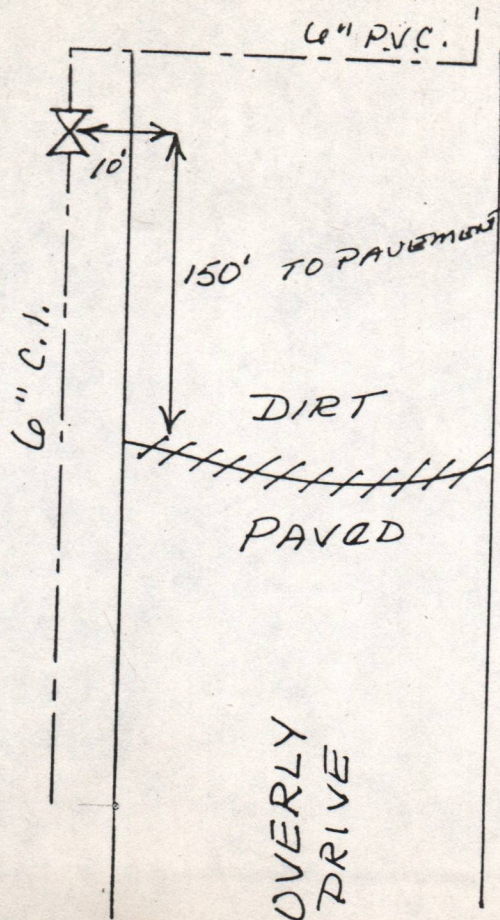


14-1

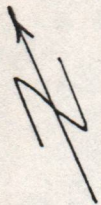

TO
HERITAGE
TANK

S5W5