


S5W6

14-2

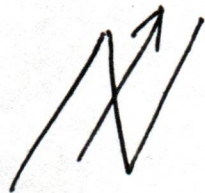

MOSS LANE

BELLWOOD

6" ACP

OLD LOWER FALLS ROAD

6" PVC

24 CURB STOP

THIS VALVE IS CLOSED

MOSS LANE

6" PVC

