


55W6

2-1

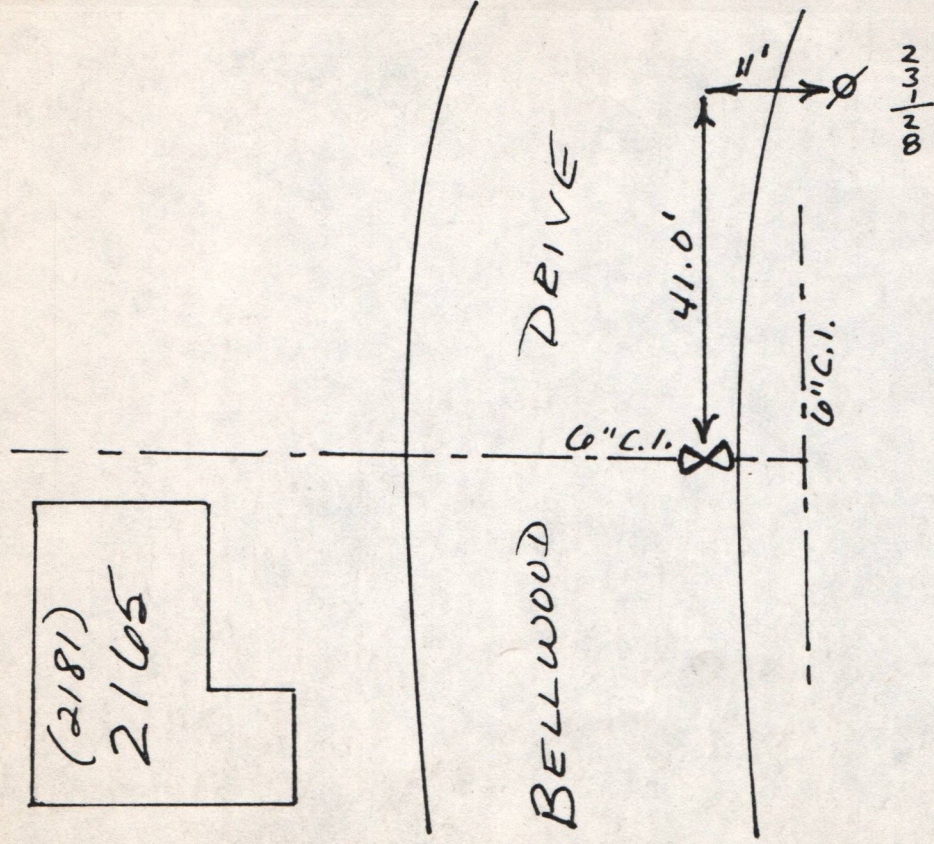

N