


55W6

2-2



BELLWOOD DR.

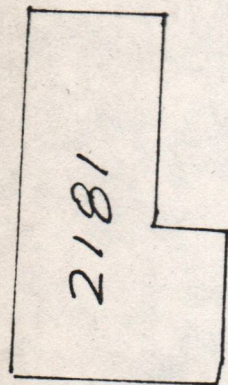