


8-2

S5W6

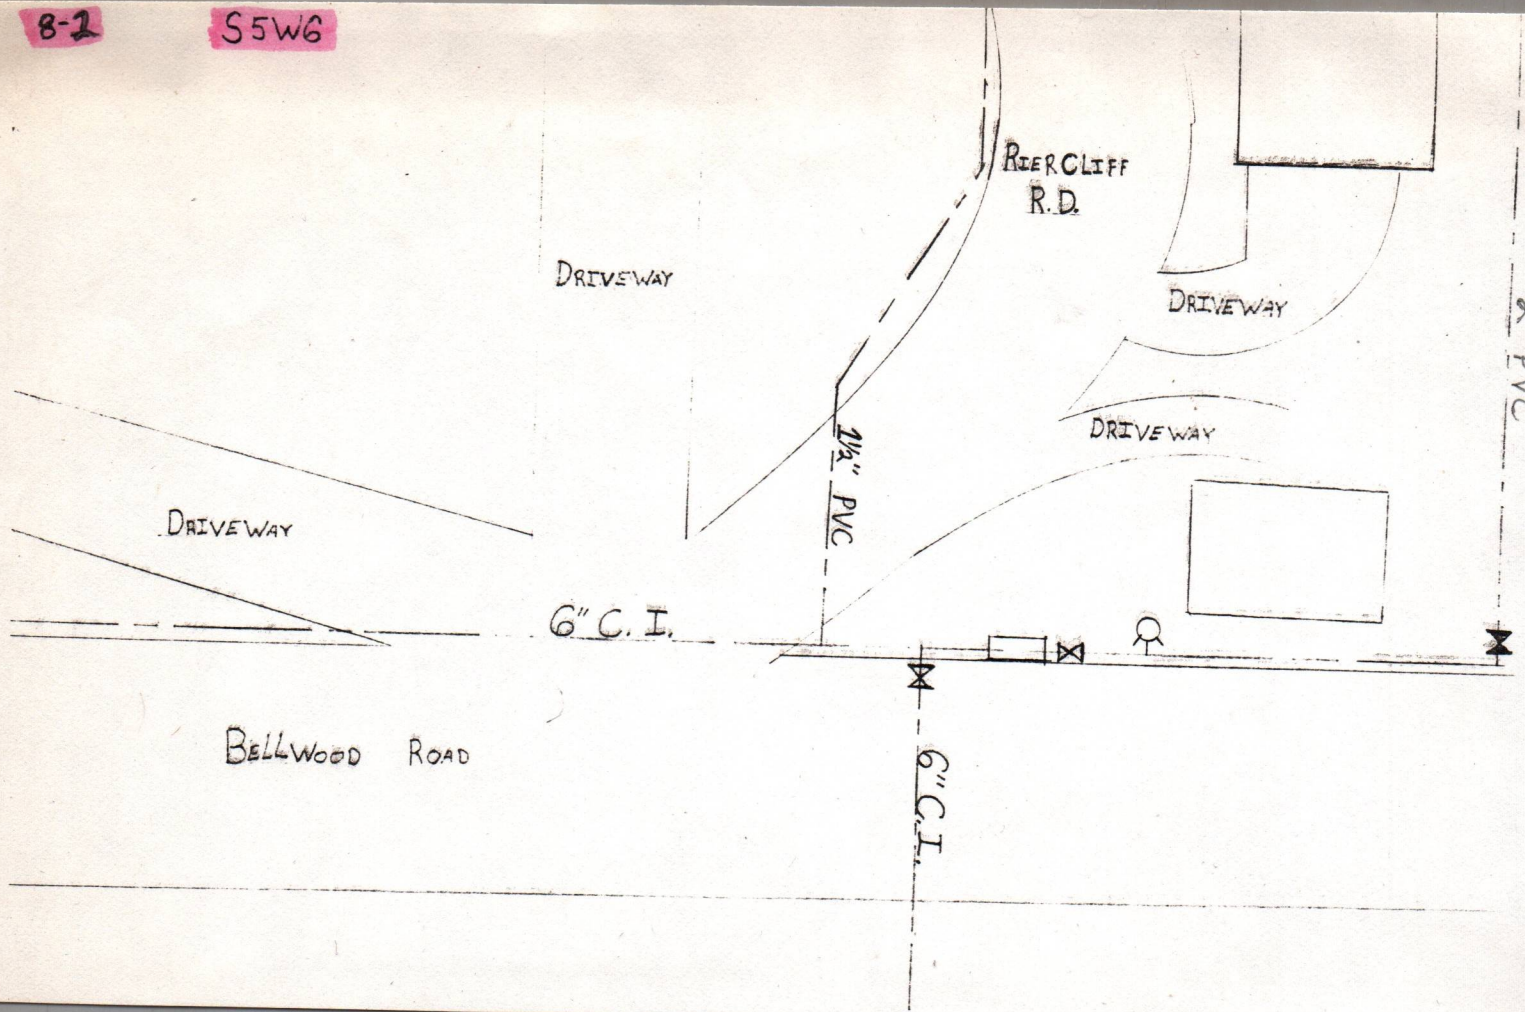

REM CO.

TORRANCE, CA

SPOT CLEAR