


8-2

SSW7

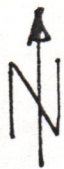

2645

6" C.I.

3" PVC



13'

2'

R

HILLTOP DRIVE

2648

CHECK
MEASUREMENTS