
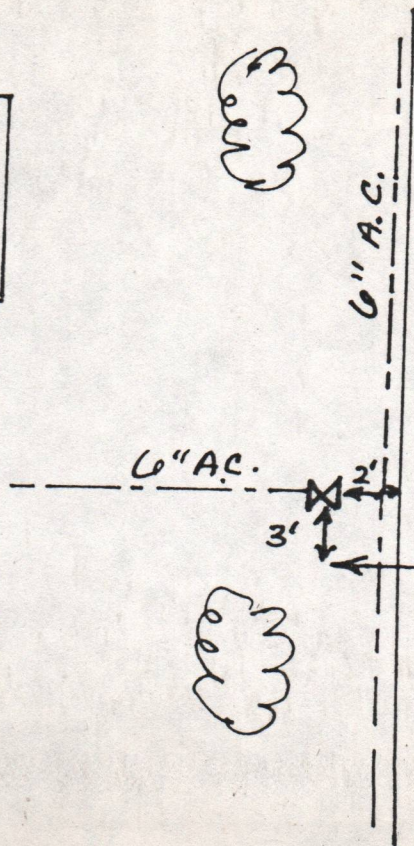
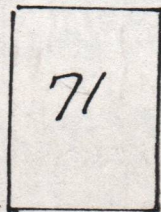




SBW6

7-1

DOGWOOD ROAD

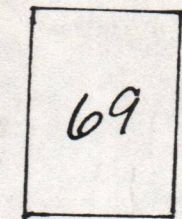

HERITAGE DRIVE

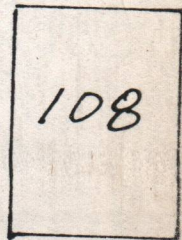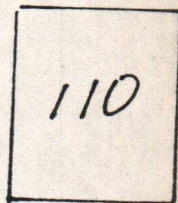

Ø T.P.