


23-1

S8W7

MARTIN
ESTATE

WALL

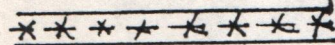

9.0'

3.0'

4.0'

6.0'

6" A.C.

RIVERBEND ROAD



C & O RRY



TO
RIVERBEND

